

REVISION	DATE	DESCRIPTION	B
A	01JUL2020	50% BD ISSUE	JJ
B	28AUG2020	90% BD ISSUE	JJ
C	27NOV2020	DESIGN ISSUE	JJ
D	12FEB2021	30% DD ISSUE	RL
E	07JUL2021	BID ISSUE	RL
F	06AUG2021	90% DD ISSUE	RL






R. Dr. Cesário Mota Júnior, 424 - Villa Buarque, São Paulo - SP, 01221-020

REVISION HISTORY

- 1 REV. 0 - JUMPER TAGS ADDED.
2 REV. 0 - LINE 370229 ADDED.
3 REV. 0 - HV 370221 ADDED.
4 REV. 0 - CV 370207 ADDED.
5 REV. 0 - DRIP TRAY ADDED.

MARKUP | LEGEND

 ADDITIONS
 DELETIONS
 NOTES

CONFIDENTIAL

THE INFORMATION CONTAINED HEREIN MAY NOT BE USED OR
REPRODUCED IN ANY MANNER WITHOUT WRITTEN PERMISSION
OF INTEGRATED PROJECT SERVICES.

CLIP



Hemobrás
Empresa Brasileira de Hemoderivados e Biotecnologia

BURITI EPCMV

DRAWING TITLE


**P&I DIAGRAM
DRUG SUBSTANCE
BUFFER DOCKING LARGE
& BUFFER HOLD LARGE**

ENGINEER JJR	ARCHITECT BJE	DESIGNER RBN	IPS PROJECT # ITD19439.01
DRAWN BY RBN	REVIEWED BY GJC	SCALE NONE	CADD FILE NAME 7B-Z-0-2-39

XREF FILE(S)

REVISION
0
A
VERSION

7B-Z-0-2-39

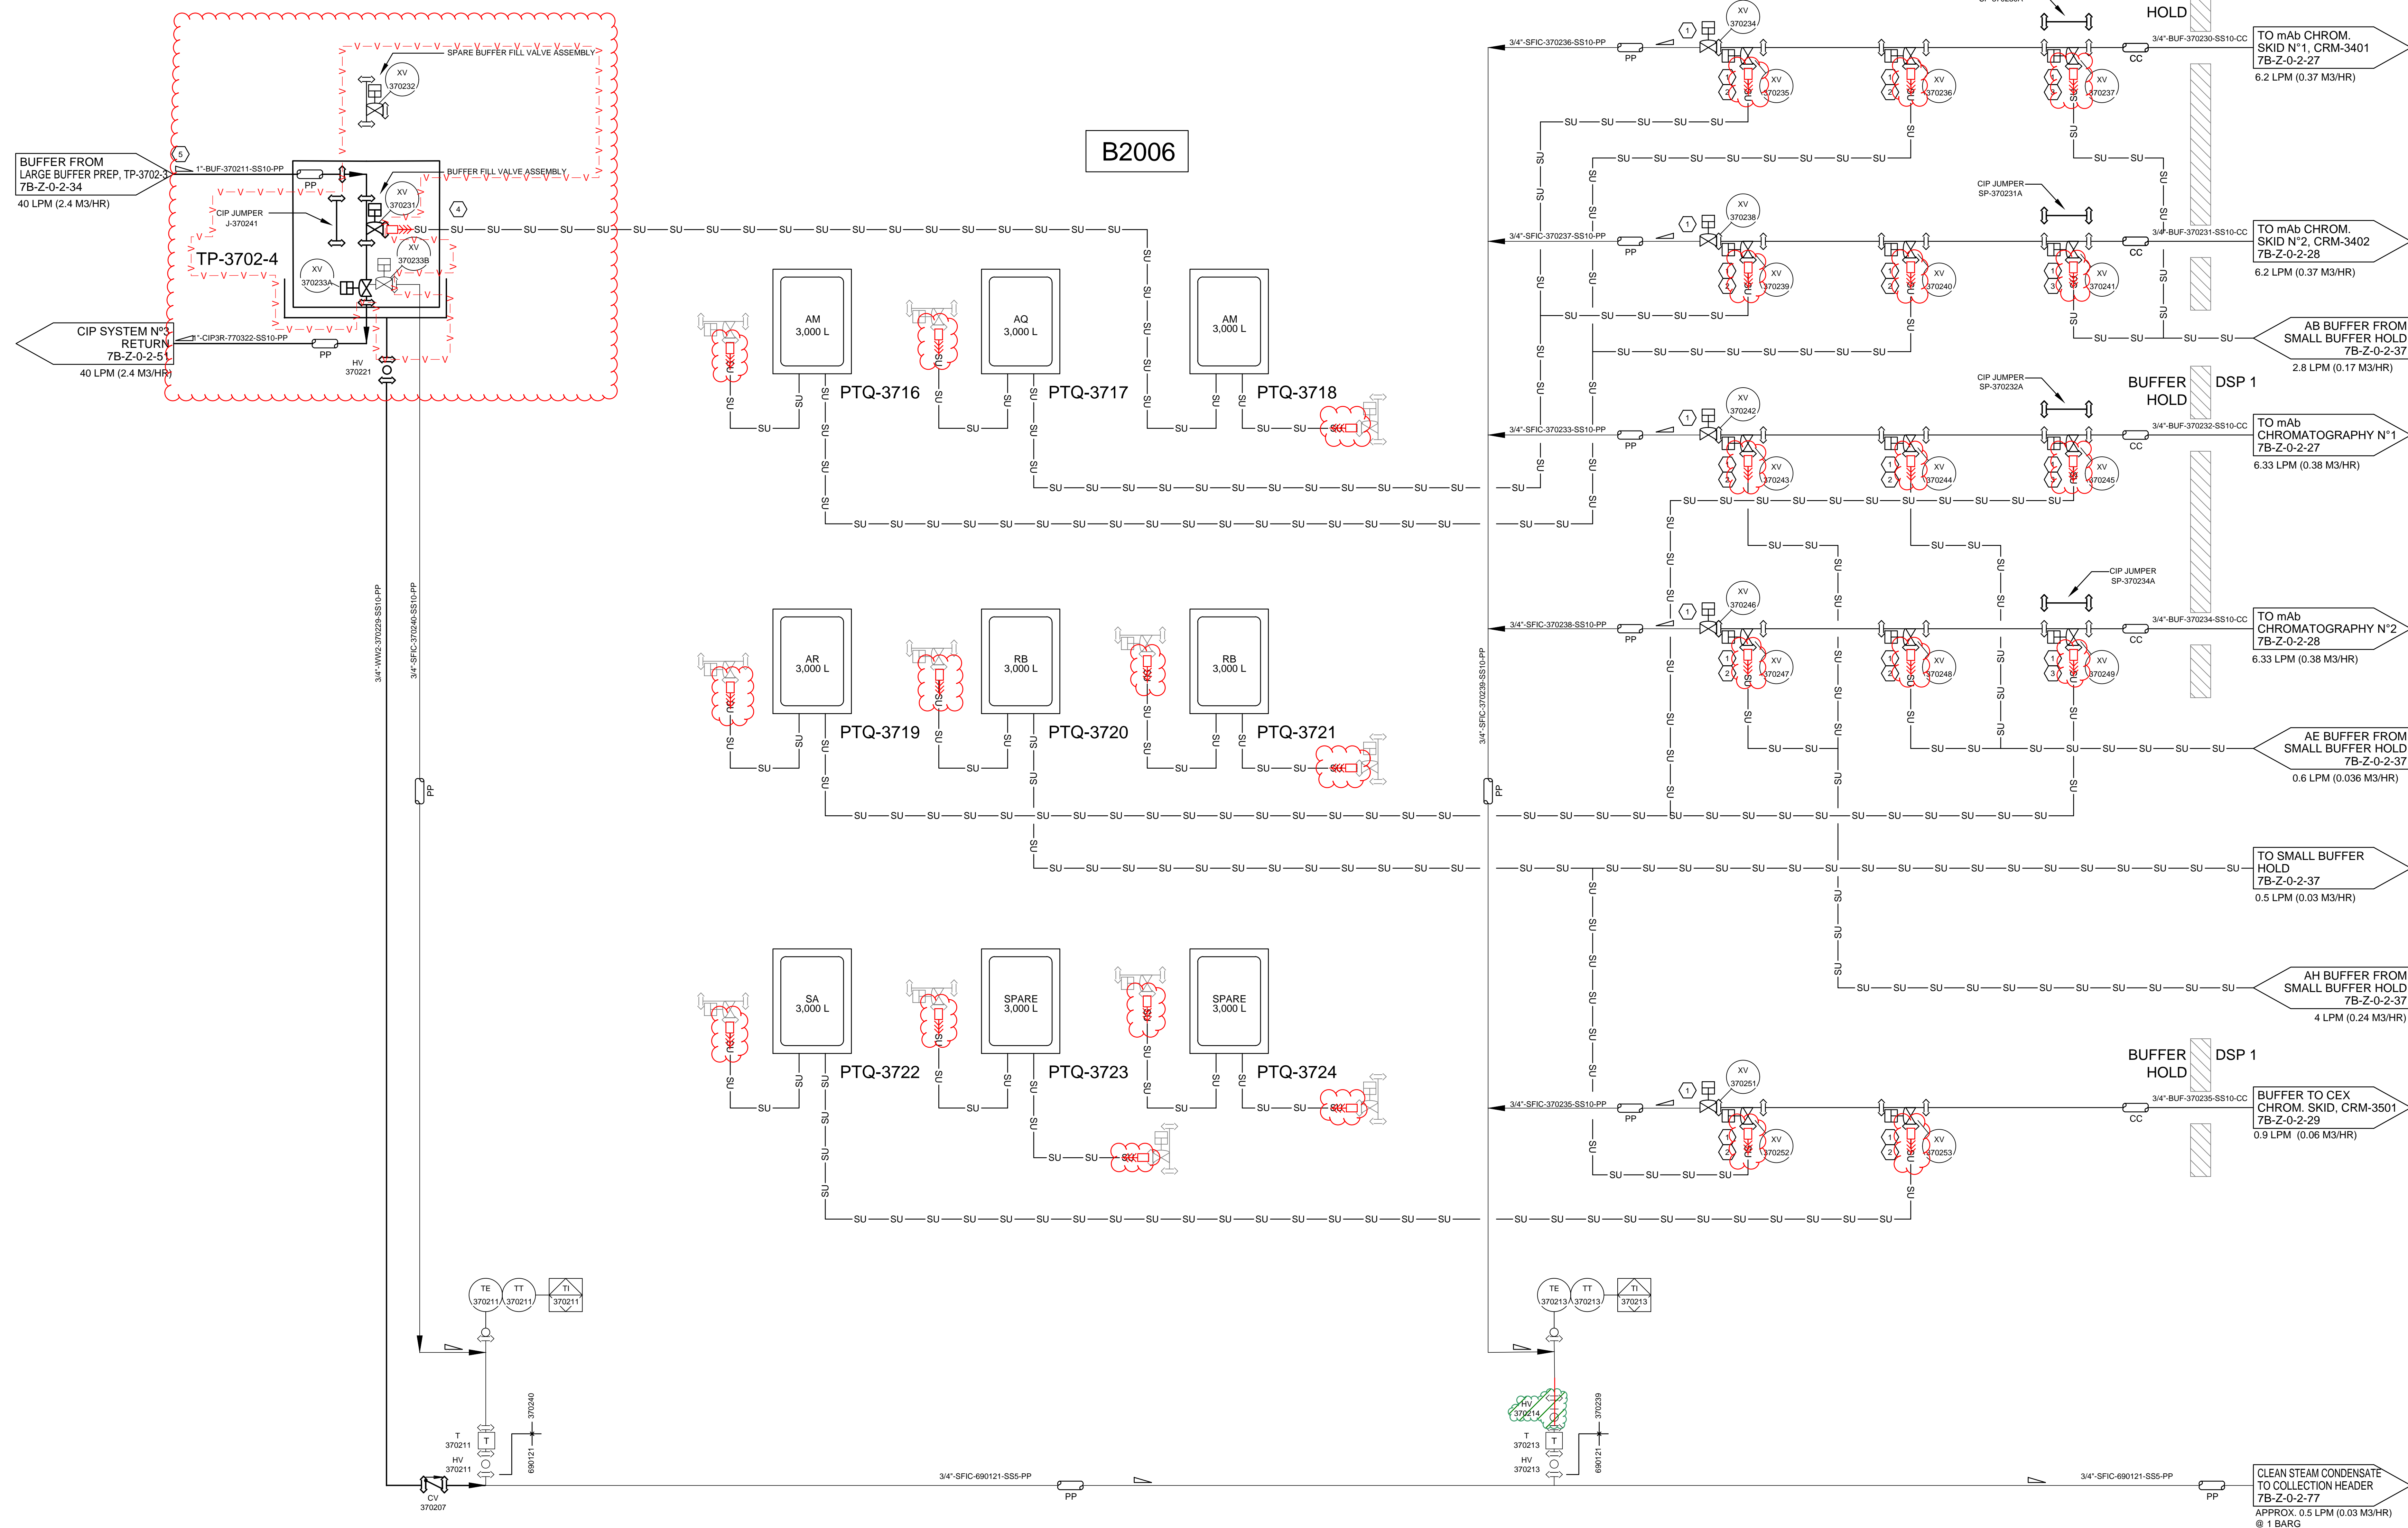

PTQ-3716
BUFFER PALLETANK
TYPE: NON-JACKETED, FIXED
CAPACITY: 3000L
SIZE: TBD
MOC: 304L SS / SILICONE BAG

PTQ-3717
BUFFER PALLETANK
TYPE: NON-JACKETED, FIXED
CAPACITY: 3000L
SIZE: TBD
MOC: 304L SS / SILICONE BAG

PTQ-3718
BUFFER PALLETANK
TYPE: NON-JACKETED, FIXED
CAPACITY: 3000L
SIZE: TBD
MOC: 304L SS / SILICONE BAG

PTQ-3719
BUFFER PALLETANK
TYPE: NON-JACKETED, FIXED
CAPACITY: 3000L
SIZE: TBD
MOC: 304L SS / SILICONE BAG

PTQ-3720
BUFFER PALLETANK
TYPE: NON-JACKETED, FIXED
CAPACITY: 3000L
SIZE: TBD
MOC: 304L SS / SILICONE BAG

PTQ-3721
BUFFER PALLETANK
TYPE: NON-JACKETED, FIXED
CAPACITY: 3000L
SIZE: TBD
MOC: 304L SS / SILICONE BAG

PTQ-3722
BUFFER PALLET TANK
TYPE: NON-JACKETED, FIXED
CAPACITY: 3000L
SIZE: TBD
MOC: 304L SS / SILICONE BAG

PTQ-3723
BUFFER PALLET TANK
TYPE: NON-JACKETED, FIXED
CAPACITY: 3000L
SIZE: TBD
MOC: 304L SS / SILICONE BAG

PTQ-3724
BUFFER PALLET TANK
TYPE: NON-JACKETED, FIXED
CAPACITY: 3000L
SIZE: TBD
MOC: 304L SS / SILICONE BAG

TP-3702-4
TRANSFER PANEL
TYPE: HYGIENIC, CUSTOM
DUTY: BUFFER FILL
SIZE: TBD
MOC: 316L SS
ASSEC: CIPSPPOOL PIECE

ISSUED FOR
CONSTRUCTION

SEAL

THIS IS NOT A
SEALED DOCUMENT

DATE: _____