


N:\2019\194399.DWG: 19 Project Drawings\Process\7B-BD\7B-Z-0-2-04.dwg 9/22/21 08:53:51 PM: M. Nelson

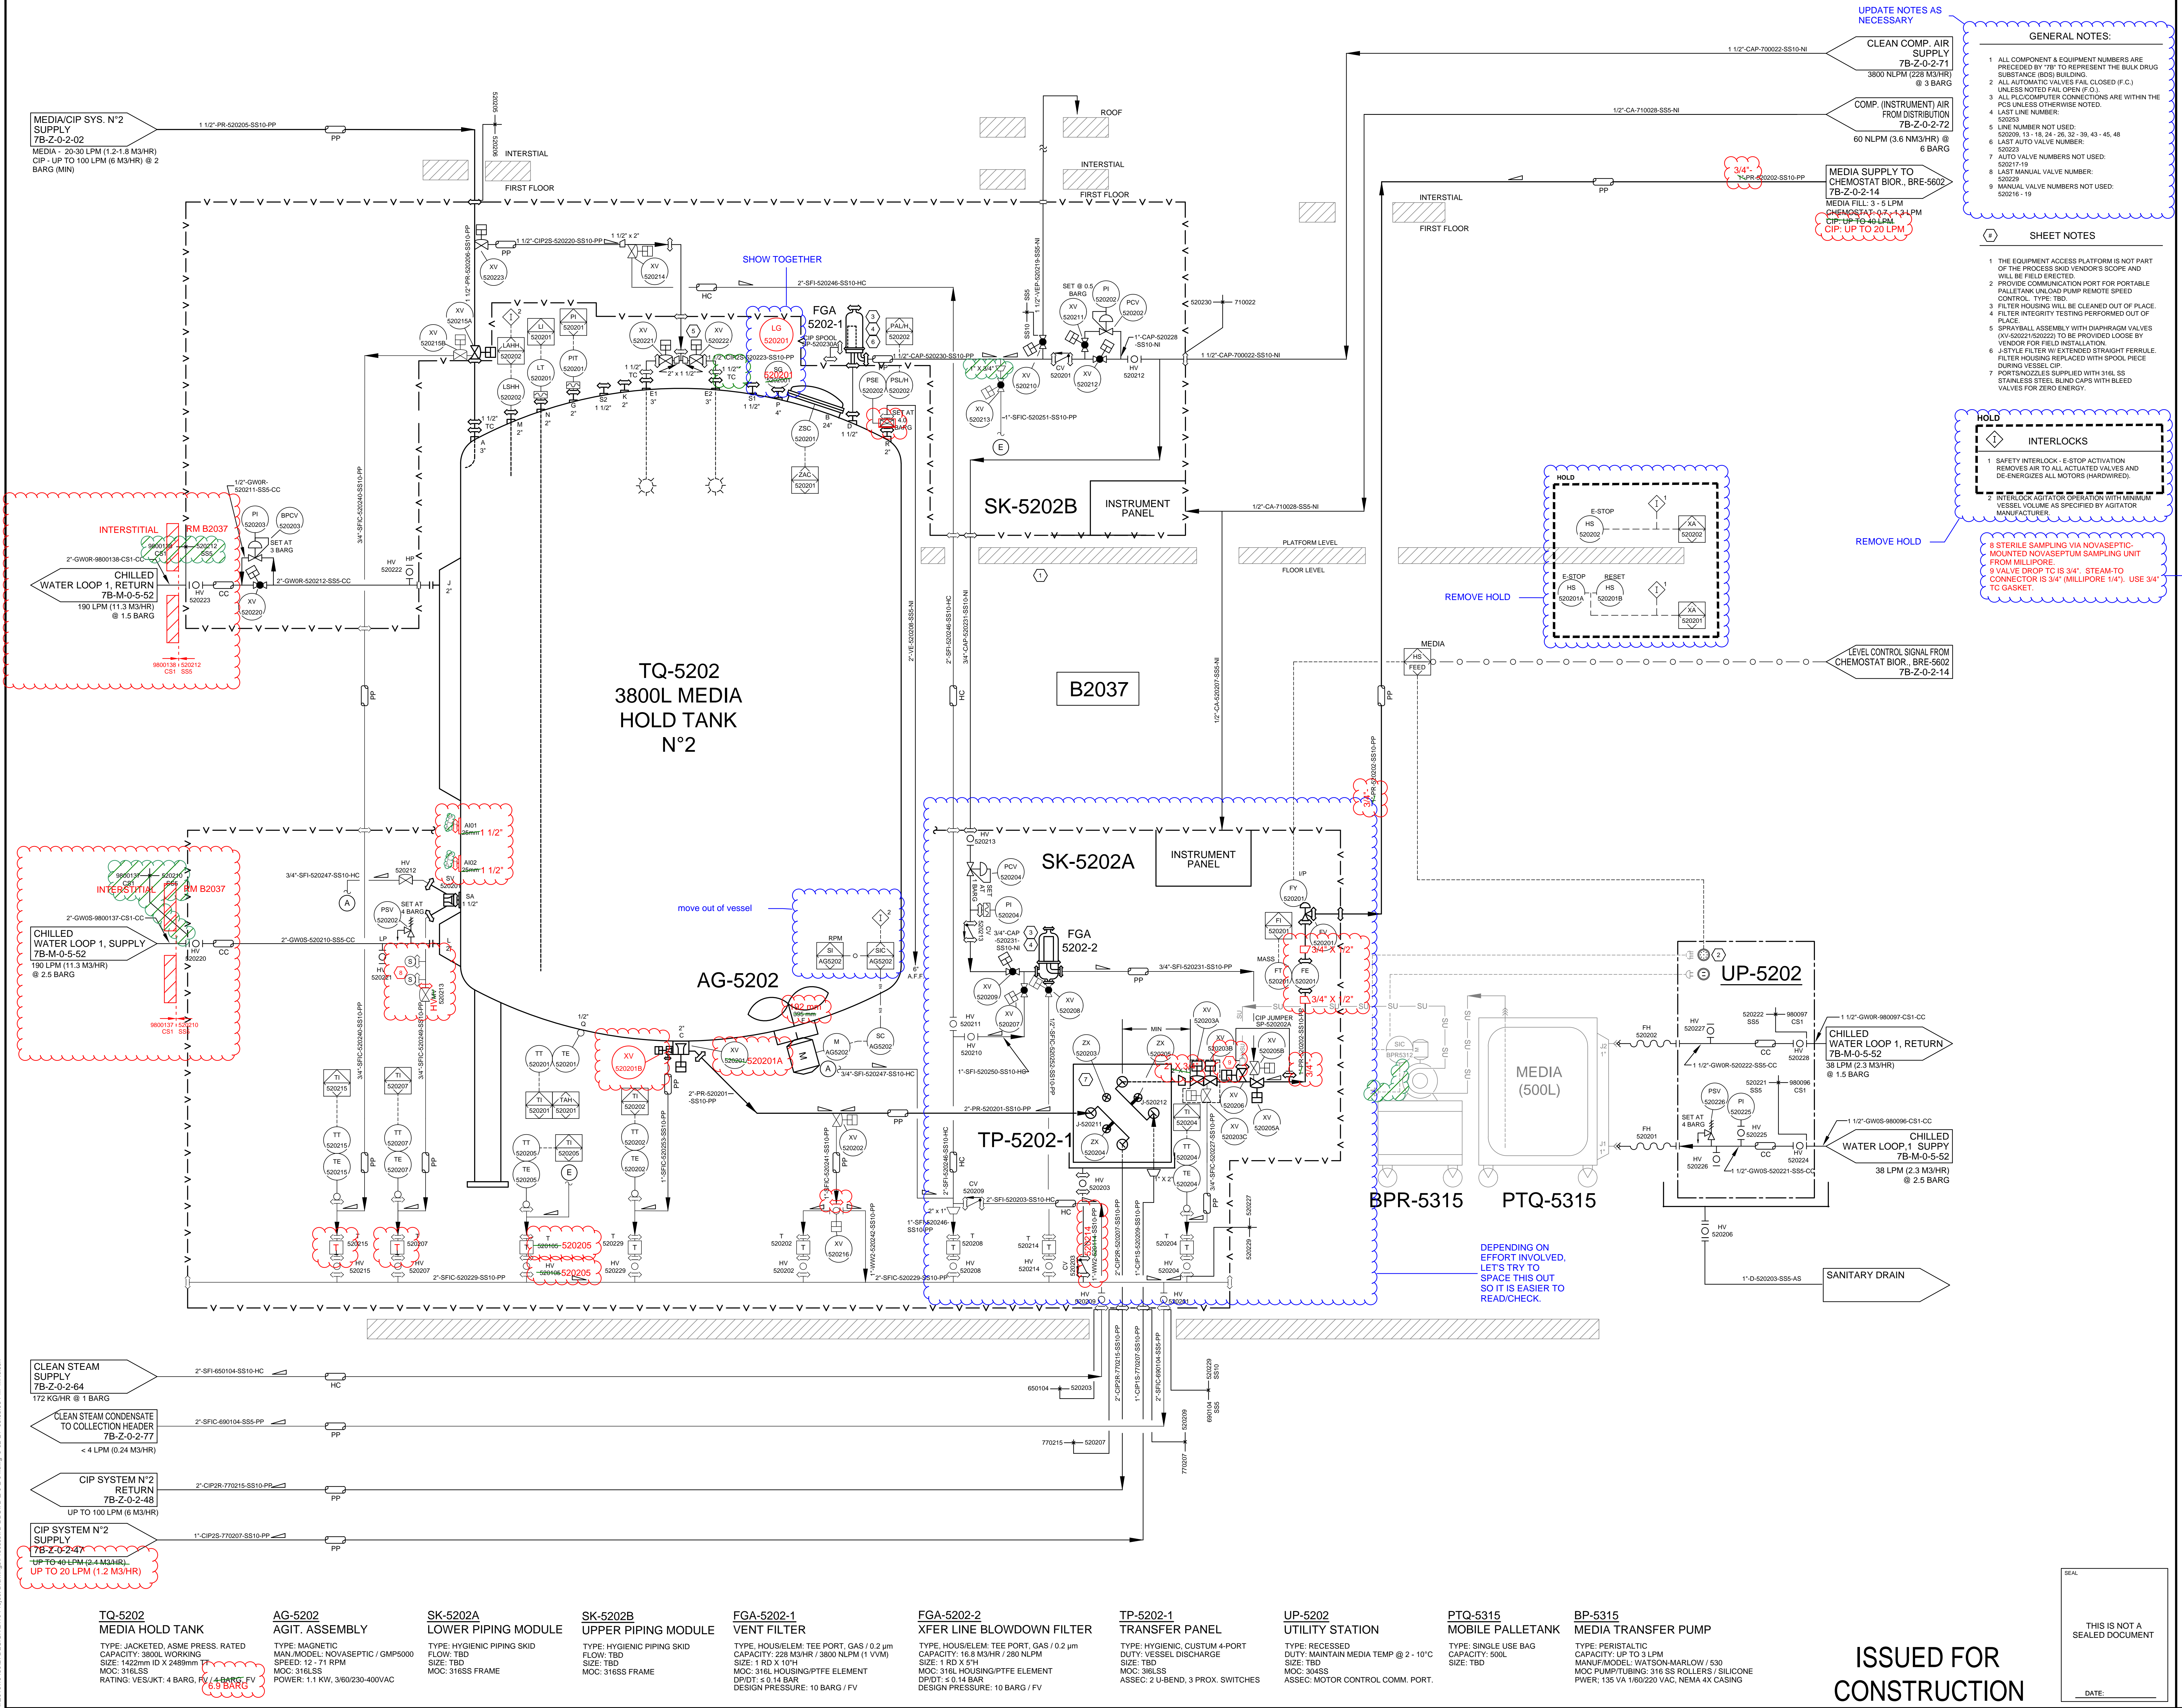

**Integrated Project Services**

Engineering  
Design/Build  
Construction  
Consulting

721 Arbor Way  
Suite 100  
Blue Bell, PA 19422  
Phone: (610) 828-4090  
Fax: (610) 828-3656  
www.ipsdb.com

IPS Professional Engineers and Architects, LLC.

REVISION	DATE	DESCRIPTION	BY
A	28/05/2020	90% BD ISSUE	JJR
B	27/09/2020	DESIGN ISSUE	JJR
C	12/02/2021	90% DD ISSUE	RLD
D	02/06/2021	CONSTRUCTION ISSUE	RLD

**DRAFT**  
**INTERIM P&ID REDLINES**  
03JUN2022

R. Dr. Cesarino Mota Junior, 434 - Vila Buarque, São Paulo - SP, 01221-020

**REVISION HISTORY**

- REV. 0 - TAGS FOR JUMPERS ADDED.
- REV. 0 - STEAM TO CONNECTION ADDED TO CONNECTION FROM TP-5202-1 TO CHEMOSTAT BIORACTOR FEED.
- REV. 0 - XY 520224 DELETED.
- REV. 0 - LINE 520241 DELETED.
- REV. 0 - LINE 520241 UPDATED TO 520242.
- REV. 0 - CHILLED WATER LINE SIZE UPDATED.

**MARKUP LEGEND**

ADDITIONS

DELETIONS

NOTES

**CONFIDENTIAL**

THE INFORMATION CONTAINED HEREIN MAY NOT BE USED OR REPRODUCED IN ANY MANNER WITHOUT WRITTEN PERMISSION OF INTEGRATED PROJECT SERVICES.

BURITI EPCMV

**P&ID DIAGRAM**  
**DRUG SUBSTANCE**  
**3800L MEDIA HOLD TANK**  
**N°2, TQ-5202**

ENGINEER	ARCHITECT	DESIGNER	IPS PROJECT #
JJR	BJE	JJR	ITD19439.01

DRAWN BY	REVIEWED BY	SCALE	CADD FILE NAME
GJC	NONE	7B-Z-0-2-04	

XREF FILE(S)	DRAWING NUMBER

**REVISION**  
0  
A  
VERSION

**7B-Z-0-2-04**

THIS IS NOT A SEALED DOCUMENT

DATE: \_\_\_\_\_

**ISSUED FOR CONSTRUCTION**